



FOUNDATION NOTES (SEE GRADE BEAM DETAILS)
 PROVIDE PIERS UNDER GRADE BEAMS AT ALL SPOT FOOTING LOCATIONS
 WHERE TOP OF FOOTING (T.F.) IS LOWER THAN 294.5".
 PIERS UNDER EXTERIOR GRADE BEAMS 9" O.C. OR 12" O.C. OTHERS 8" O.C. OR 12" O.C.
 4 #4 VERTICALS IN ALL PIERS EXTENDING UP 20" INTO GRADE BEAMS,
 WITH #2 TIES @ 8" O.C. THIS APPLIES AT ALL COLUMN AND/OR
 SPOT FOOTING LOCATIONS WHETHER PIER IS THERE OR NOT.
 4 #4 DOWELS 24" LONG (2 1/2") IN ALL SPOT FOOTINGS.
 FOR FOOTING DETAILS & REINFORCING SEE SCHEDULE OF FOOTINGS
 ON ANOTHER SHEET.
 FOR ELEVATION OF TOP OF FOOTINGS SEE "T.F." ON PLANS.
 4 #4 CONTINUOUS IN ALL GRADE BEAMS (2 TOP- 2 BOTTOM)
 #2 STIRRUPS (NOT SHOWN) @ 24" O.C. IN ALL GRADE BEAMS.

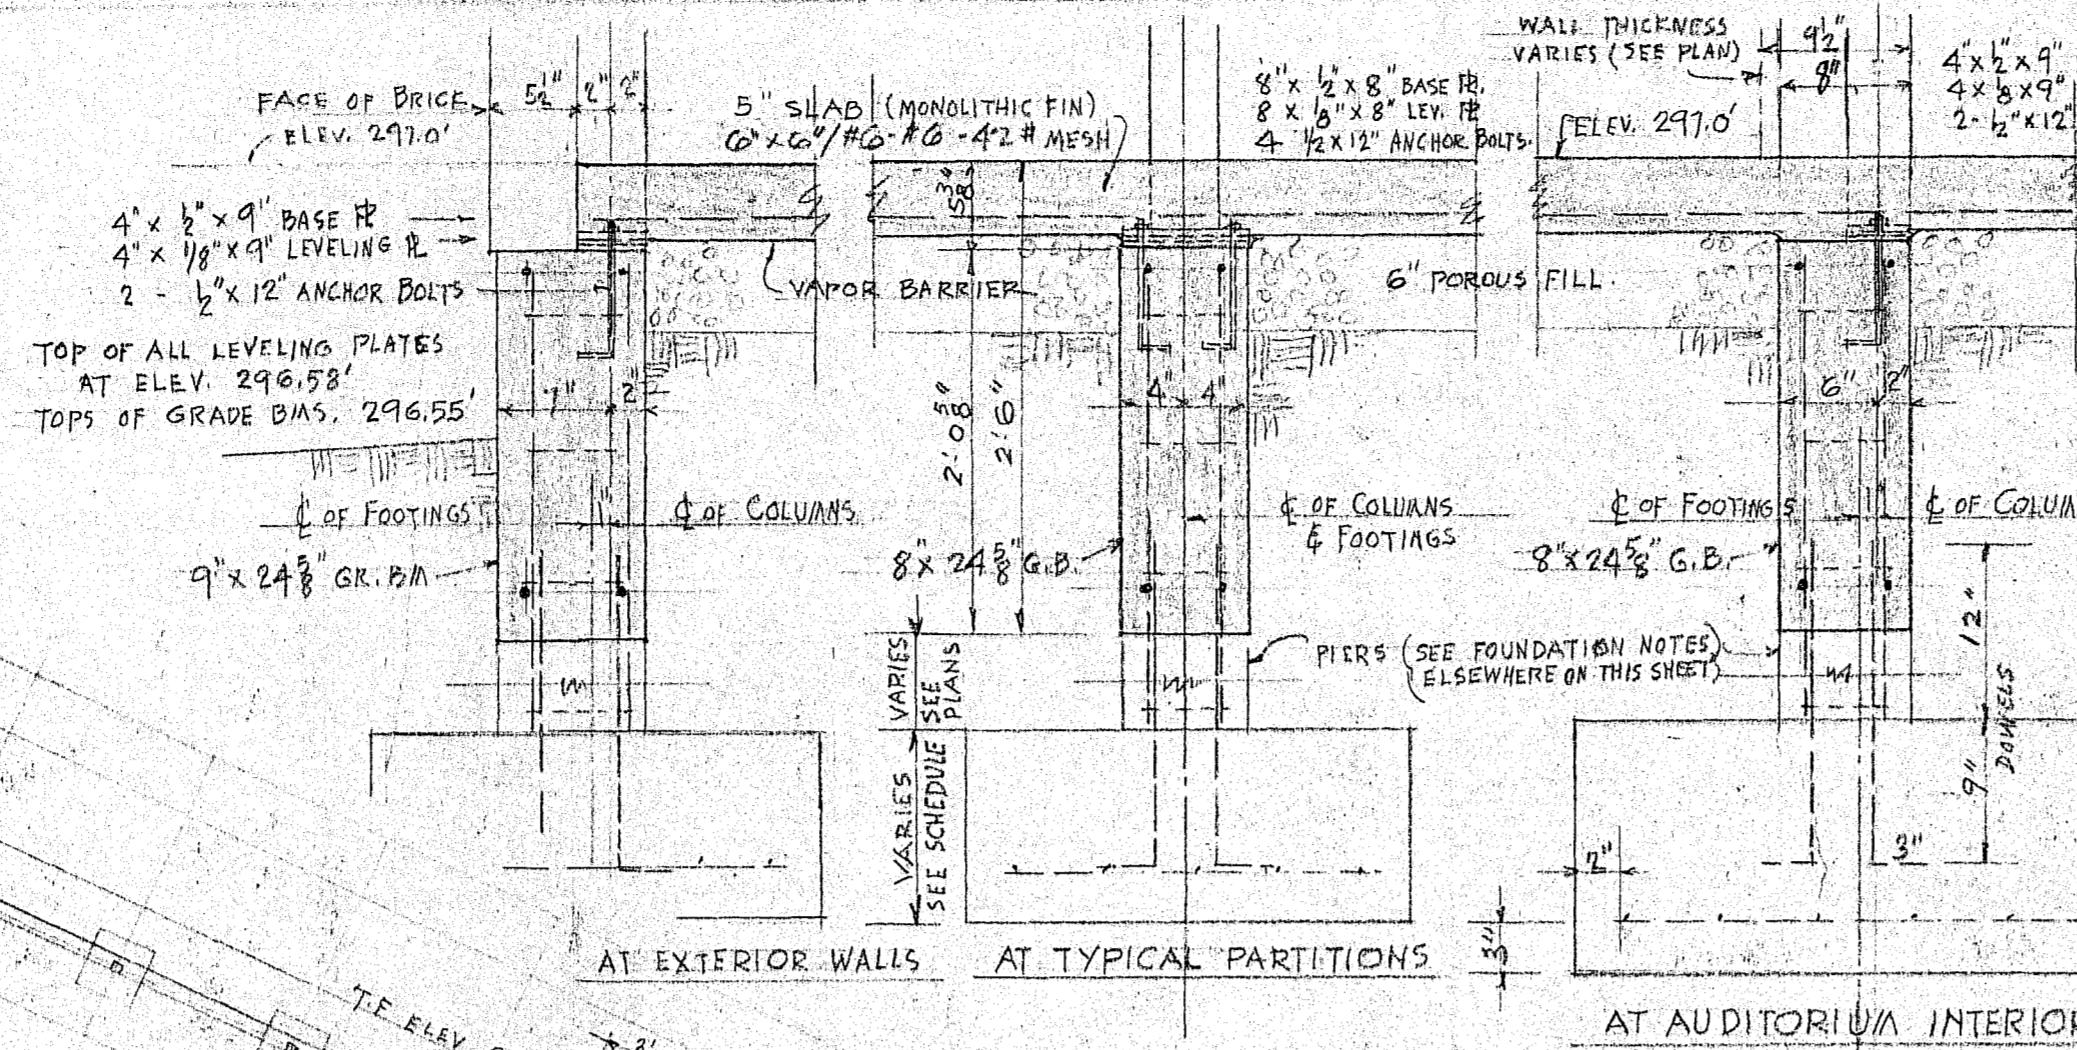


GRADE BEAM DETAILS

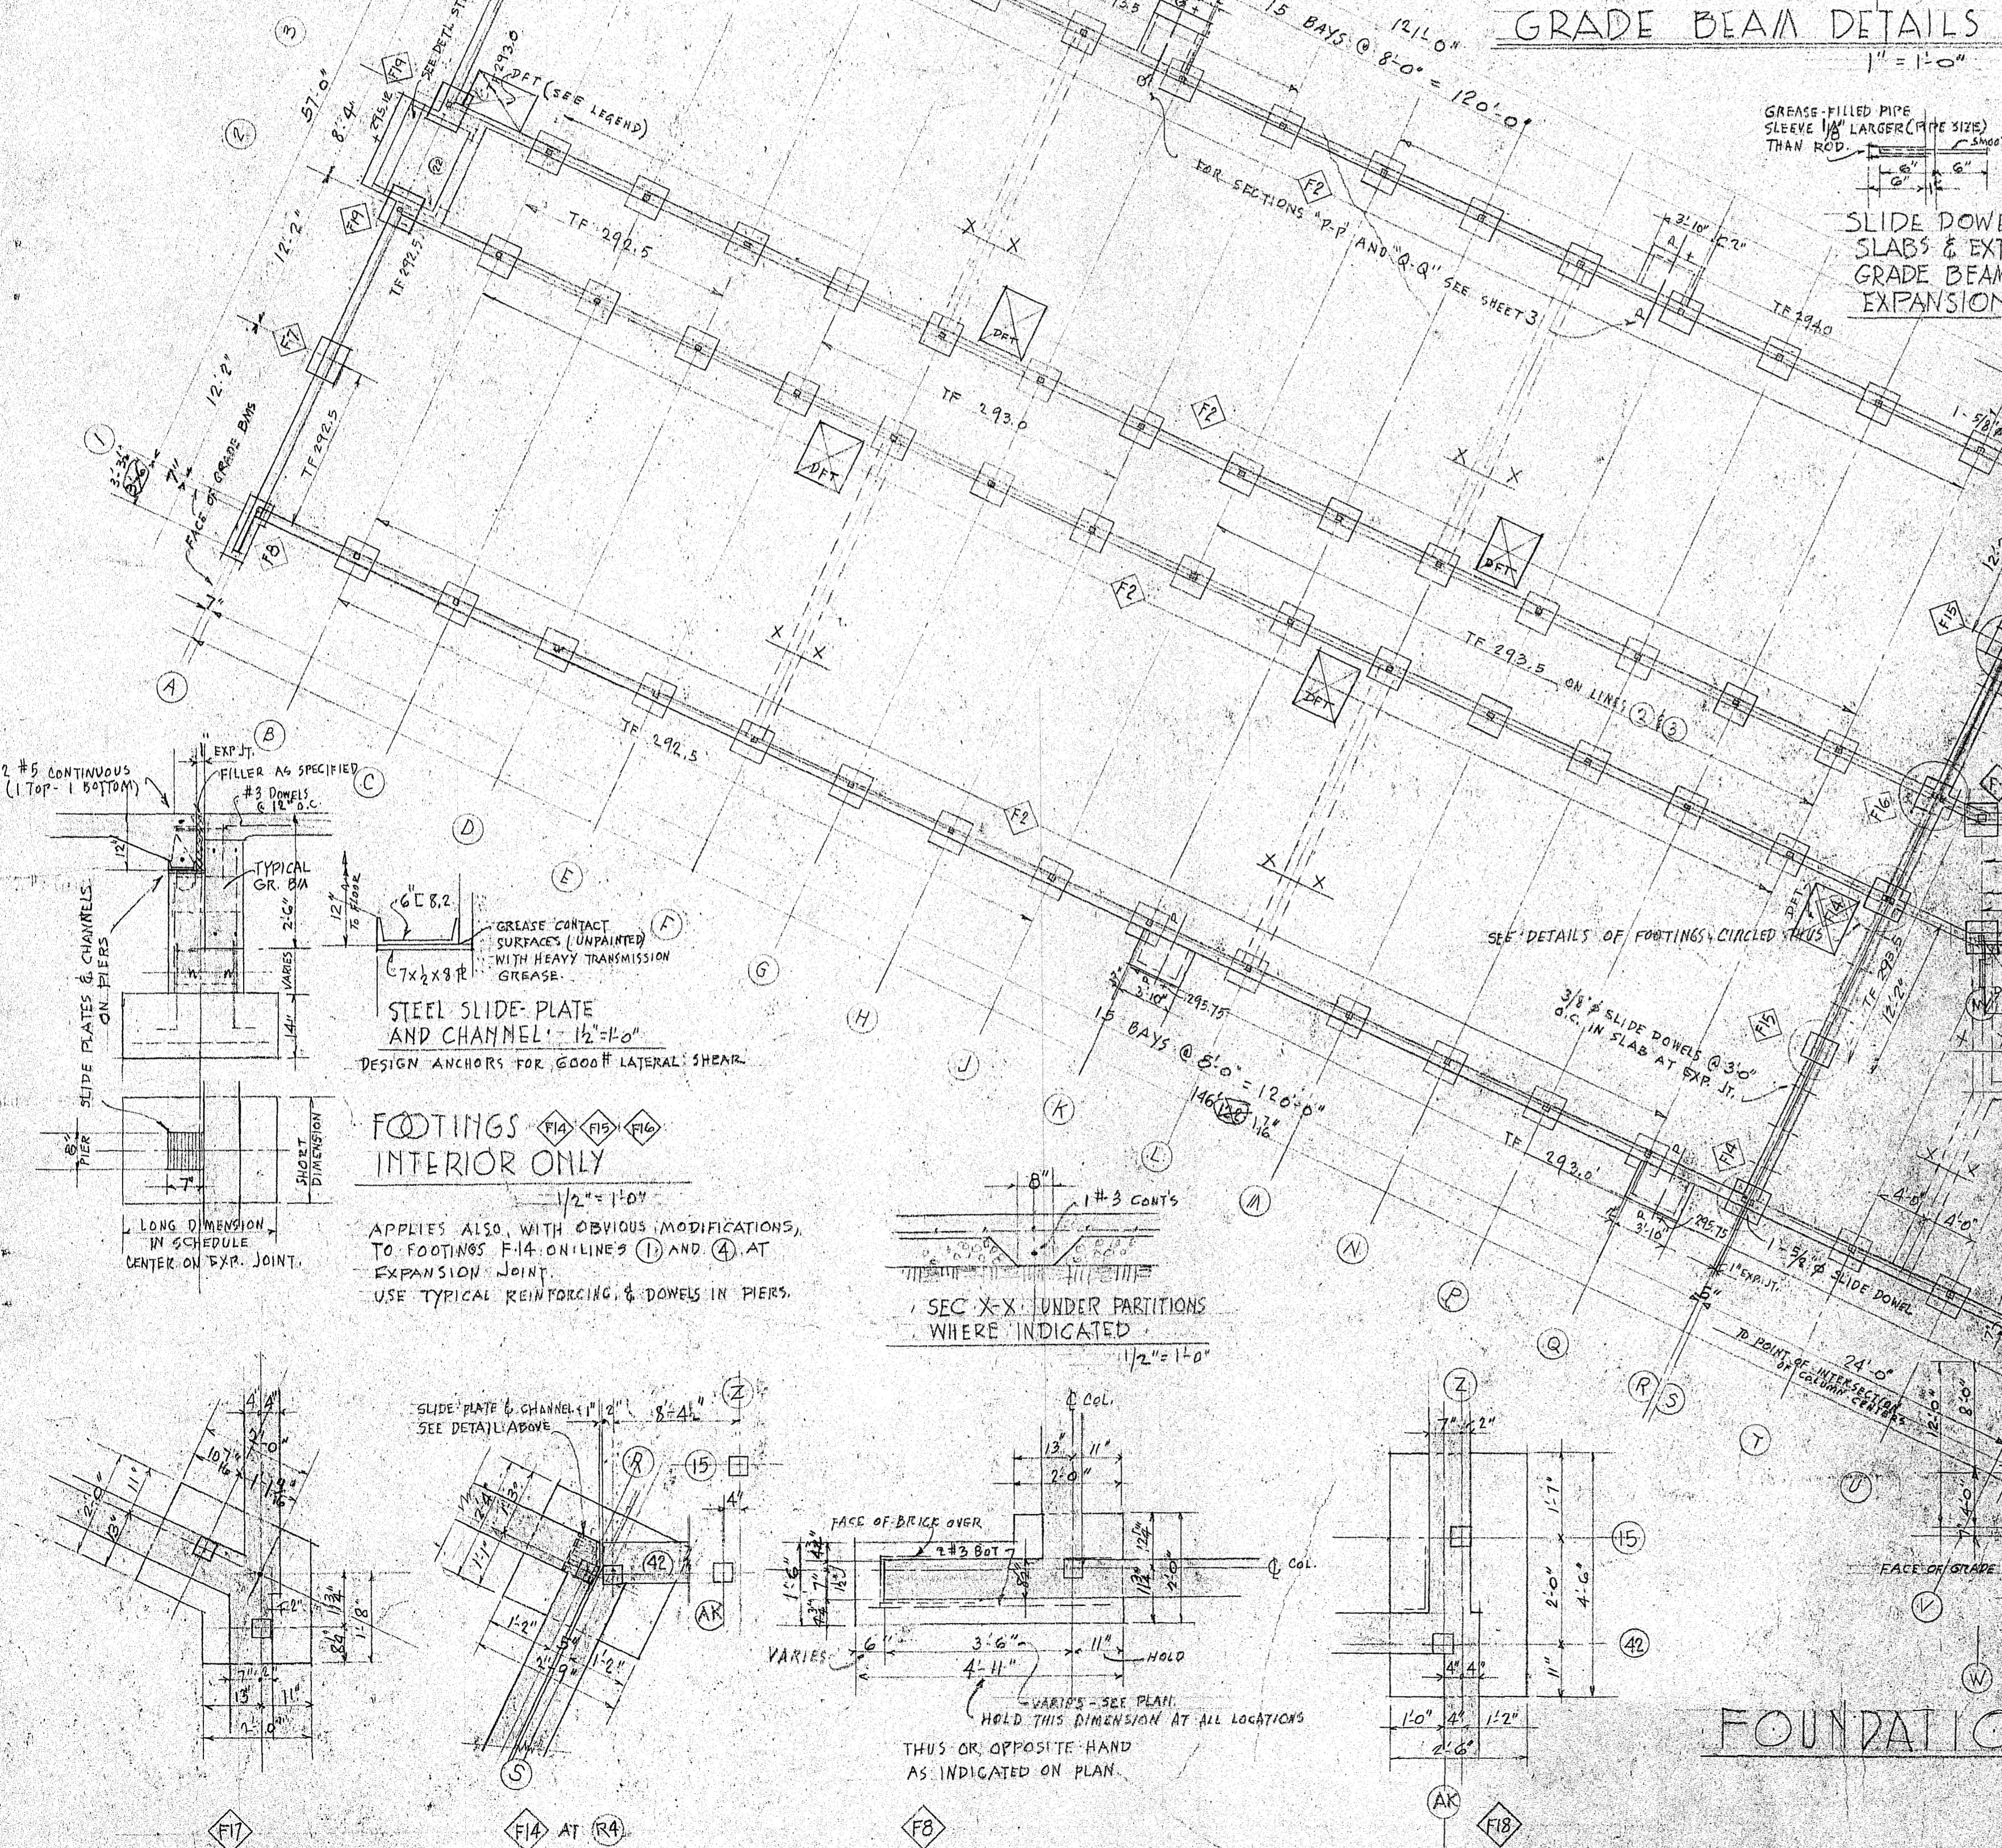

SPECIAL FOOTING DETAILS

1/2" = 1'-0"

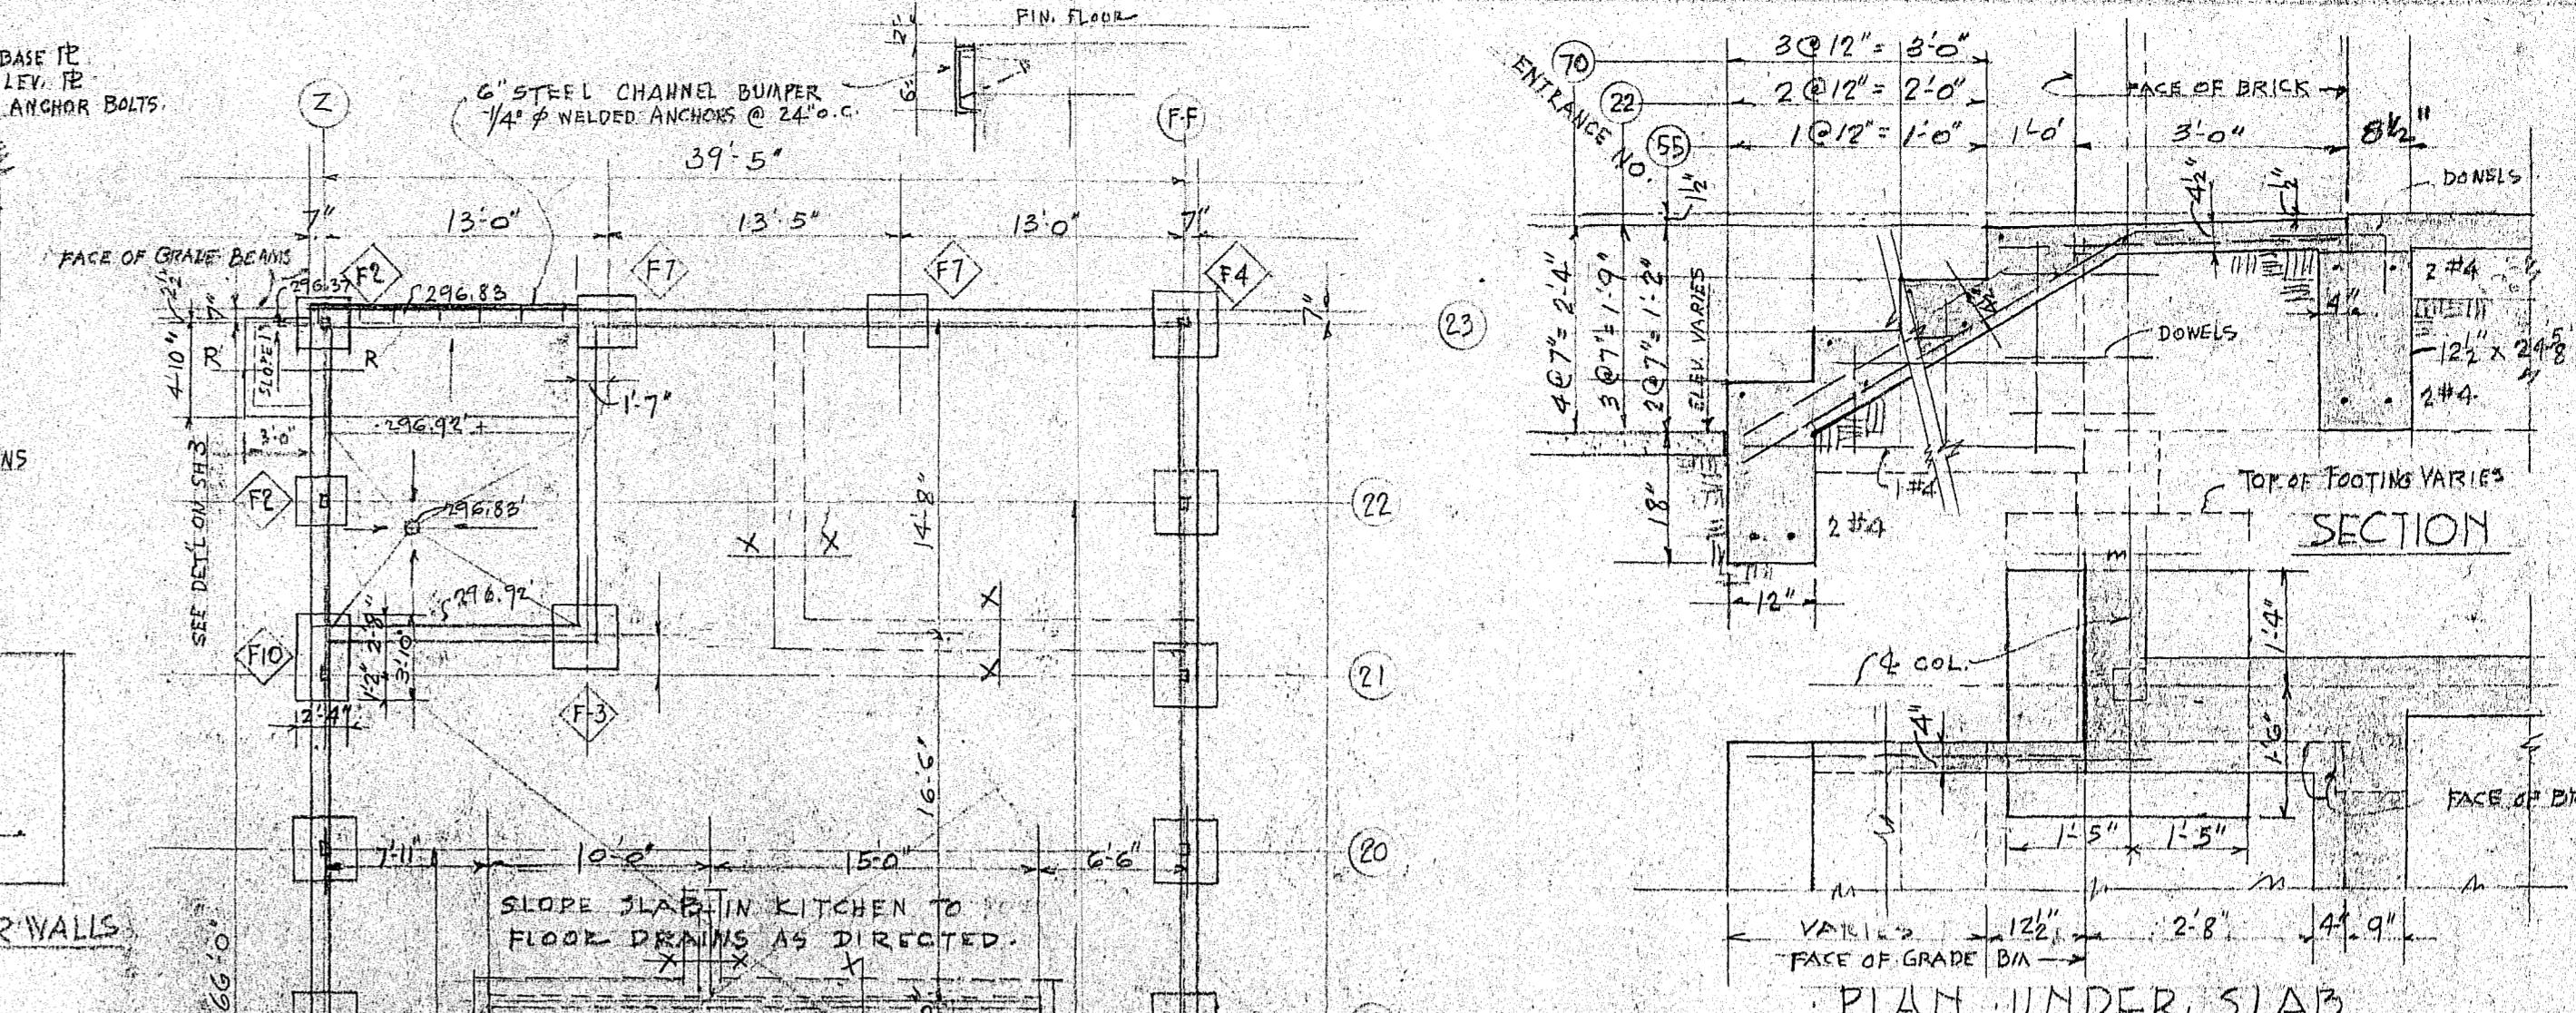

DETAIL OF STEPS AT ENTRANCES #22, #55 & #70

REINFORCING NOTES:
 BOTTOM STEP: 2 #4 BOTTOM.
 SIDE WALLS: #3 @ 12" O.C. HOR. & VERT.
 SLAB (PLATFORM & STEPS) #3 @ 6" O.C. - ALT. BENT. (1 - #4 BOTTOM)
 TEMPERATURE: #3 @ 11" O.C.
 STEP NOSINGS: 1 #3 EACH.
 DOWELS AT ALL JOINTS TO MATCH ALL HORIZONTAL STEEL.

LEGEND

- 4x4 STEEL COLUMN LOCATION.
- (F) FOOTING & TYPE-MARK - SEE SCHEDULE.
- GRADE BEAM - SEE DETAILS.
- (A) COORDINATES OF COLUMN CENTERS - FOR REFERENCE.
- (F) INDICATES THAT SYMBOL SHOWN ON LINE APPLIES TO ALL FOOTINGS INCLUDED WITHIN LIMITS INDICATED BY ARROW POINTS (INCLUSIVE). WHERE ON CORRIDOR CENTER, APPLIES TO BOTH SIDES OF CORRIDOR.
- TF 2940 TOP OF FOOTING ELEV. 294.0'
- DFT DEPRESS SLAB FOR TILE 1/2". FOR DIMENSIONS AND EXACT LOCATIONS SEE ARCHITECTURAL PLANS.


GENERAL NOTES

CONCRETE MIXES: FOOTINGS AND SLABS
 GRADE BEAMS, PIERS & OTHER 2500#
 FLOOR SLABS: 5" THICK, 6KG/46X46 WELDED WIRE MESH 3000#
 SLAB FINISHES: APPLIED SEPARATELY IN PATROL COAT
 PAINTED ROOMS, COLORING ELSEWHERE APPLIED
 FINISHES TO BE REINFORCED WITH CHICKEN WIRE
 DIMENSIONS GENERALLY TO COLUMN CENTERS AND TO
 FACE OF EXTERIOR GRADE BEAMS.
 ENTRANCE PORCH SLABS AND STEPS ARE NOT TO BE
 POURED UNTIL AT LEAST TWO WEEKS AFTER FULL
 STRUCTURAL LOAD IS ON BUILDING.
 CONSTRUCTION JOINTS IN BEAMS ARE TO BE MADE
 WITH BULKHEADS PLACED VERTICALLY AND AT
 RIGHT ANGLES TO FACES OF BEAMS. LOCATE
 ONLY AT MIDSPANS.
 UNIT SOIL PRESSURE USED FOR FOOTINGS: 1,800 PSF
 ELEVATION TOP OF FLOOR SLAB 297.0' EXCEPT WHERE NOTED.
 NO FINISH REQUIRED IN PIPE SPACE BETWEEN
 BOYS' & GIRLS' TOILET ROOMS.

FOUNDATION PLAN - PART A

4'8" = 1'-0"

PART A
PART B

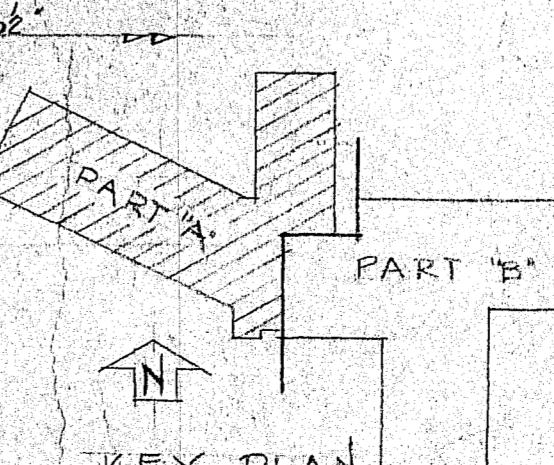

"AS-BUILT" 10-30-59.

ROBERT E. LEE ELEMENTARY SCHOOL
 JACKSON, MISSISSIPPI
 FOR THE TRUSTEES OF THE
 JACKSON MUNICIPAL SEPARATE SCHOOL DISTRICT

DRAWN BY: JAY T. LIDDLE & EUGENE D. DRUMMOND
 CHECKED BY: ASSOCIATED ARCHITECTS & ENGINEERS
 DATE: AUG 26, 1968
 JACKSON - MISSISSIPPI